

Date: Friday, 17/08/2007 11:21:14 AM  
 User: Linda Lacelle

## Process Sheet

|                                  |                                       |                         |                        |
|----------------------------------|---------------------------------------|-------------------------|------------------------|
| <b>Customer</b>                  | : CU-DAR001 Dart Helicopters Services | <b>Drawing Name</b>     | : BLOWER MOTOR SUPPORT |
| <b>Job Number</b>                | : 34083                               |                         |                        |
| <b>Estimate Number</b>           | : 12309                               |                         |                        |
| <b>P.O. Number</b>               | : N/A                                 | <b>Part Number</b>      | : D3471043             |
| <b>This Issue</b>                | : 17/08/2007                          | <b>S.O. No.</b>         | : N/A                  |
| <b>Prsht Rev.</b>                | : NC                                  | <b>Drawing Number</b>   | : D3471 REV.A          |
| <b>First Issue</b>               | : N/A                                 | <b>Project Number</b>   | : N/A                  |
| <b>Previous Run</b>              | : 28559                               | <b>Drawing Revision</b> | : A                    |
|                                  |                                       | <b>Material</b>         | : N/A                  |
| <b>Written By</b>                | : <i>[Signature]</i>                  | <b>Due Date</b>         | : 11/09/2007           |
| <b>Checked &amp; Approved By</b> | : <i>[Signature]</i>                  | <b>Qty:</b>             | 8                      |
| <b>Comment</b>                   | : est rev A 06.03.02 New issue EC     | <b>Um:</b>              | Each                   |

## Additional Product

Job Number:



|                |                              |                      |
|----------------|------------------------------|----------------------|
| <b>Seq. #:</b> | <b>Machine Or Operation:</b> | <b>Description :</b> |
|----------------|------------------------------|----------------------|

|     |           |       |
|-----|-----------|-------|
| 1.0 | MS3584216 | CLAMP |
|-----|-----------|-------|



**Comment:** Qty.: 1.0000 Each(s)/Unit Total : 8.0000 Each(s)  
 pick:

|     |             |             |                                   |
|-----|-------------|-------------|-----------------------------------|
| Qty | Part number | Description | Batch                             |
| 1   | MS35842-16  | CLAMP       | M10540825 / M10076123 FF 07-09-06 |

|     |            |       |
|-----|------------|-------|
| 2.0 | MS20427M44 | RIVET |
|-----|------------|-------|



**Comment:** Qty.: 3.0000 Each(s)/Unit Total : 24.0000 Each(s)  
 pick:

|     |             |             |                                    |
|-----|-------------|-------------|------------------------------------|
| Qty | Part number | Description | Batch                              |
| 3   | MS20427M4-4 | Rivet       | M100393218 / M10540825 FF 07-09-06 |

|     |        |         |
|-----|--------|---------|
| 3.0 | D34713 | SUPPORT |
|-----|--------|---------|



**Comment:** Qty.: 1.0000 Each(s)/Unit Total : 8.0000 Each(s)  
 pick:

|     |             |             |                      |
|-----|-------------|-------------|----------------------|
| Qty | Part number | Description | Batch                |
| 1   | D3471-3     | Support     | B9410327<br>B2612621 |

FF 07-09-06

|     |             |                               |
|-----|-------------|-------------------------------|
| 4.0 | SMALL FAB 1 | SMALL & MEDIUM FAB RESOURCE 1 |
|-----|-------------|-------------------------------|



**Comment:** SMALL & MEDIUM FAB RESOURCE 1

Assemble as per dwg D3471

FF 07-09-10

# Dart Aerospace Ltd

| W/O: |      | WORK ORDER CHANGES |    |      |     |                                     |                          |
|------|------|--------------------|----|------|-----|-------------------------------------|--------------------------|
| DATE | STEP | PROCEDURE CHANGE   | By | Date | Qty | Approval<br>Chief Eng /<br>Prod Mgr | Approval<br>QC Inspector |
|      |      |                    |    |      |     |                                     |                          |
|      |      |                    |    |      |     |                                     |                          |

Part No: \_\_\_\_\_ PAR #: \_\_\_\_\_ Fault Category: \_\_\_\_\_ NCR: Yes ☒ No ☐ DQA: 12 Date: 07/09/11  
 QA: N/C Closed: \_\_\_\_\_ Date: \_\_\_\_\_

| NCR:     |      | WORK ORDER NON-CONFORMANCE (NCR)  |                             |  |                |                           |                       |                          |
|----------|------|---|-----------------------------|--|----------------|---------------------------|-----------------------|--------------------------|
| DATE     | STEP | Description of NC<br>Section A  | Corrective Action Section B |  |                | Verification<br>Section C | Approval<br>Chief Eng | Approval<br>QC Inspector |
|          |      |   | Initial<br>Chief Eng        | Action Description<br>Chief Eng  | Sign &<br>Date |                           |                       |                          |
| 07/09/06 | 4    | 3 clamp shifted when<br>Transferring Hole. Hole<br>off centre. Hole is oval<br>as well.<br>R.C. Transfer drilling from<br>Aluminum to steel, causing the<br>drill bit to wander.<br>- tell employee to use <del>Tant</del><br>Transfer Punch. | QSIWZ                       | <del>Set up and reworked</del><br>(07/09/06) (07/09/06) (07/09/06) (07/09/06)<br>Replace 3X0 3471-3 B 26126K1<br>B 334103 XZ | 07/09/06<br>FF | En<br>07/09/10            | QSIWZ                 | 1070906                  |
|          |      |   |                             |  |                |                           |                       |                          |
|          |      |   |                             |  |                |                           |                       |                          |

NOTE: Date & initial all entries

Date: Friday, 17/08/2007 11:21:14 AM  
User: Linda Lacelle

## Process Sheet

Customer: CU-DAR001 Dart Helicopters Services

Drawing Name: BLOWER MOTOR SUPPORT

Job Number: 34083

Part Number: D3471043

Job Number:



Seq. #:

Machine Or Operation:

Description :

5.0

QC5

INSPECT WORK TO CURRENT STEP



Comment: INSPECT WORK TO CURRENT STEP

EP 07/08/10 (8)

6.0

PACKAGING 1

PACKAGING RESOURCE #1



Comment: PACKAGING RESOURCE #1

Identify and Stock

Location: GA

FF 07-09-10

8

7.0

QC21

FINAL INSPECTION/W/O RELEASE



Comment: FINAL INSPECTION/W/O RELEASE

(8)  
07/09/11

Job Completion



U 07-09-11

**Dart Aerospace Ltd**

| W/O: |      | WORK ORDER CHANGES |    |      |     |                                     |                          |
|------|------|--------------------|----|------|-----|-------------------------------------|--------------------------|
| DATE | STEP | PROCEDURE CHANGE   | By | Date | Qty | Approval<br>Chief Eng /<br>Prod Mgr | Approval<br>QC Inspector |
|      |      |                    |    |      |     |                                     |                          |
|      |      |                    |    |      |     |                                     |                          |

Part No: \_\_\_\_\_ PAR #: \_\_\_\_\_ Fault Category: \_\_\_\_\_ NCR: Yes No DQA: \_\_\_\_\_ Date: \_\_\_\_\_

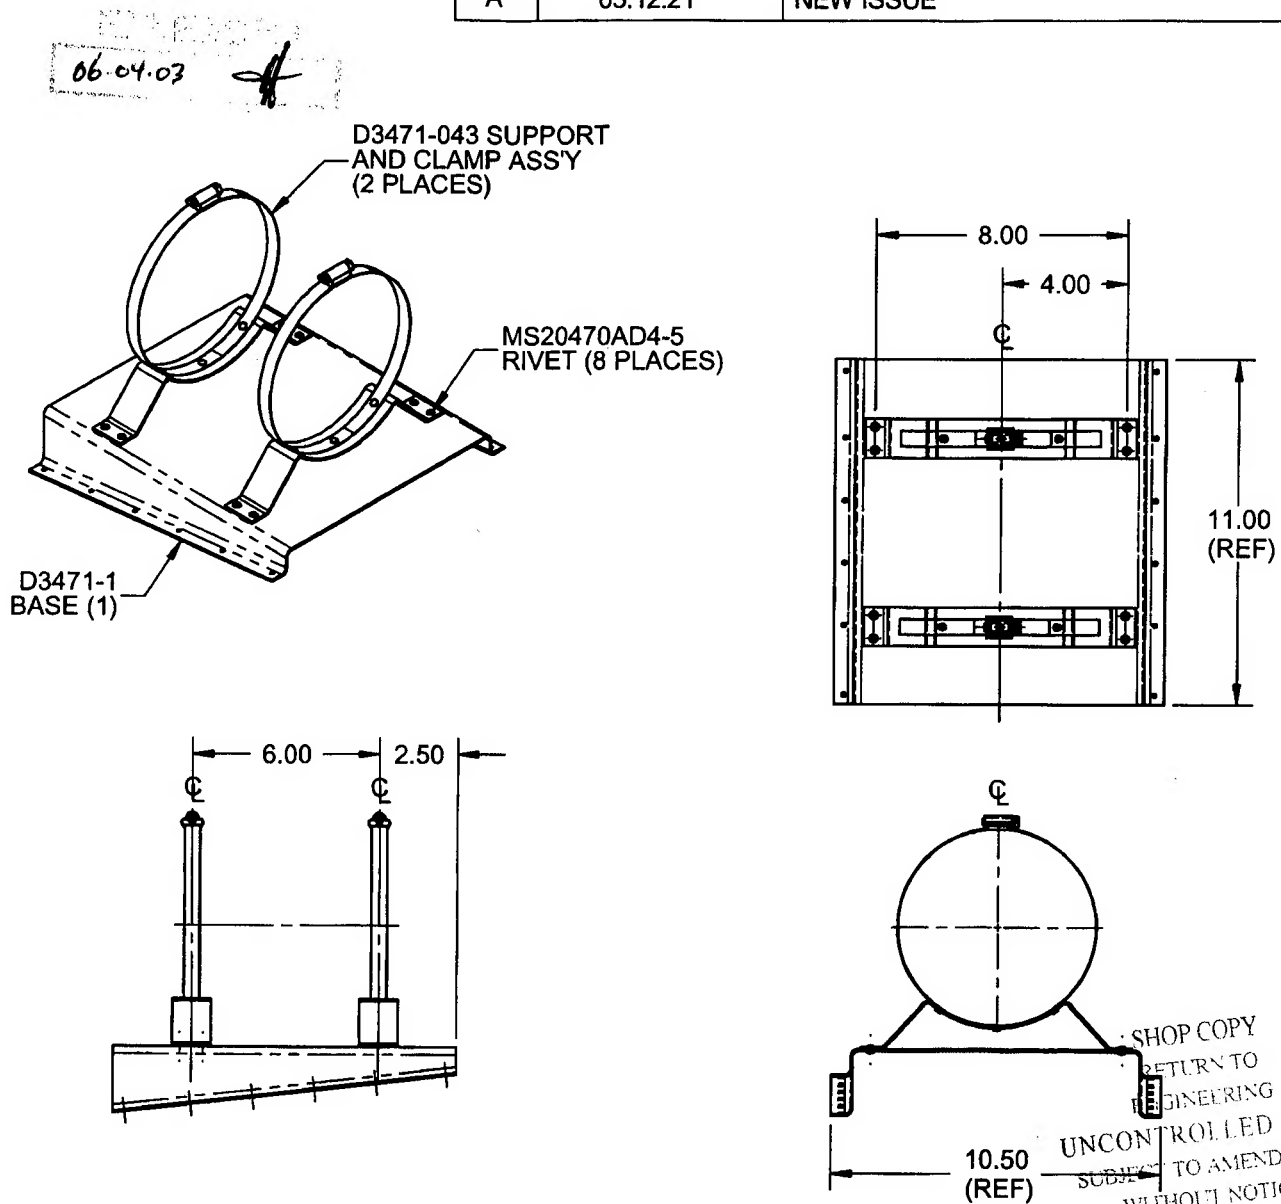
QA: N/C Closed: \_\_\_\_\_ Date: \_\_\_\_\_

| NCR: |      | WORK ORDER NON-CONFORMANCE (NCR) |                             |                                 |                |                           |                       |                          |
|------|------|----------------------------------|-----------------------------|---------------------------------|----------------|---------------------------|-----------------------|--------------------------|
| DATE | STEP | Description of NC<br>Section A   | Corrective Action Section B |                                 |                | Verification<br>Section C | Approval<br>Chief Eng | Approval<br>QC Inspector |
|      |      |                                  | Initial<br>Chief Eng        | Action Description<br>Chief Eng | Sign &<br>Date |                           |                       |                          |
|      |      |                                  |                             |                                 |                |                           |                       |                          |
**NOTE:** Date & initial all entries

**DART**

|                               |                                      |  |                        |
|-------------------------------|--------------------------------------|--|------------------------|
| DESIGN<br><i>[Signature]</i>  | DRAWN BY<br><i>[Signature]</i>       | <b>DART AEROSPACE LTD</b><br>HAWKESBURY, ONTARIO, CANADA |                        |
| CHECKED<br><i>[Signature]</i> | APPROVED<br><i>[Signature]</i>       | DRAWING NO.<br><b>D3471</b>                              | REV. A<br>SHEET 1 OF 5 |
| DATE<br><b>05.12.21</b>       | TITLE<br><b>BLOWER MOTOR SUPPORT</b> |  | SCALE<br>1:6           |
| A                             | 05.12.21                             | NEW ISSUE  |                        |

**D3471-041 BLOWER MOTOR SUPPORT****NOTES:**

- 1) IDENTIFY WITH DART P/N D3471-041 USING FINE POINT PERMANENT INK MARKER
- 2) TOLERANCES ARE PER DART QSI 018 UNLESS OTHERWISE NOTED
- 3) ALL DIMENSIONS ARE IN INCHES
- 4) BREAK ALL SHARP EDGES 0.005 TO 0.010

| QTY<br>-041 | P/N          | DESCRIPTION                |
|-------------|--------------|----------------------------|
| X           | D3471-041    | BLOWER MOTOR SUPPORT       |
| 2           | D3471-043    | SUPPORT AND CLAMP ASSEMBLY |
| 1           | D3471-1      | BASE                       |
| 8           | MS20470AD4-5 | RIVET                      |

**COPYRIGHT © 2005 BY DART AEROSPACE LTD.**

THIS DOCUMENT IS PRIVATE AND CONFIDENTIAL AND IS SUPPLIED ON THE EXPRESS CONDITION THAT IT IS NOT TO BE USED FOR ANY PURPOSE OR COPIED OR COMMUNICATED TO ANY OTHER PERSON WITHOUT WRITTEN PERMISSION FROM DART AEROSPACE LTD.



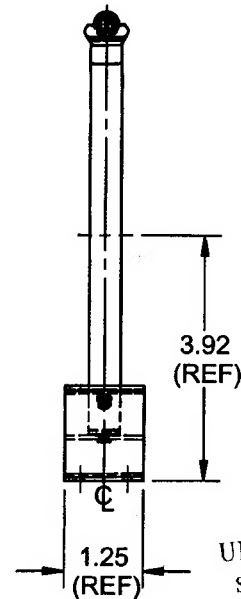
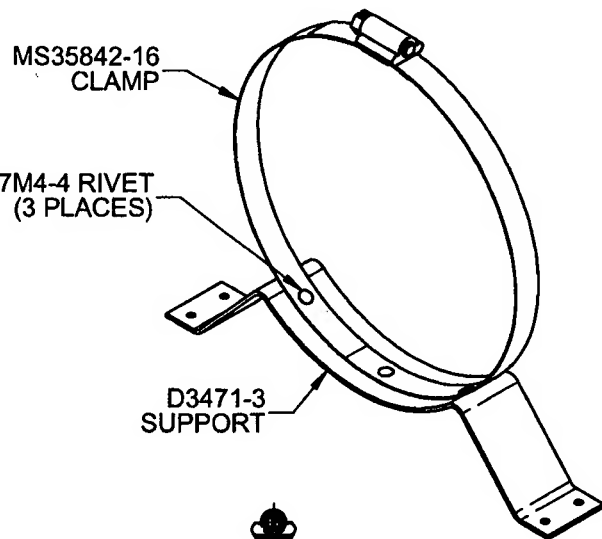
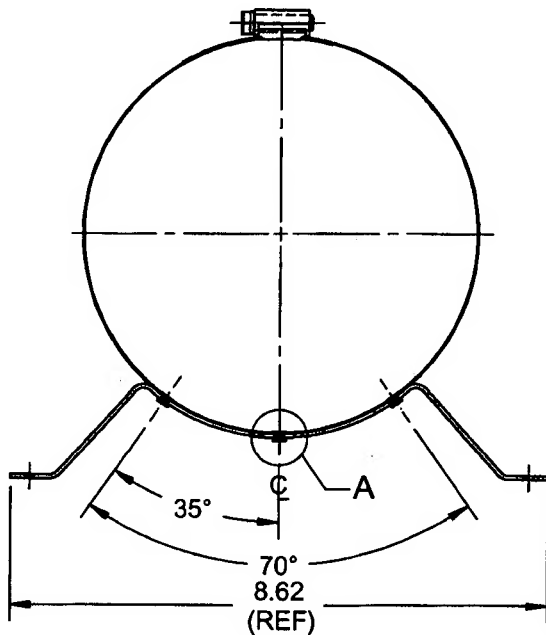
|                               |                                |   |                              |
|-------------------------------|--------------------------------|---|------------------------------|
| DESIGN<br><i>[Signature]</i>  | DRAWN BY<br><i>[Signature]</i> | DART AEROSPACE LTD<br>HAWKESBURY, ONTARIO, CANADA |                              |
| CHECKED<br><i>[Signature]</i> | APPROVED<br><i>[Signature]</i> | DRAWING NO.<br>D3471                              | REV. A                       |
| DATE<br>05.12.21              |                                | TITLE<br>BLOWER MOTOR SUPPORT                     | SHEET 2 OF 5<br>SCALE<br>1:3 |

06.04.03 *[Signature]*

LOCATE AND TRANSFER DRILL  
#30 ( $\phi 0.129$ ) THRU HOLE FROM  
D3471-3 TO MS35842-16 CLAMP  
AND C'SINK  $\phi 0.230 \times 100^\circ$   
(3 PLACES)



**DETAIL A: COUNTERSINK HOLES**  
(RIVET NOT SHOWN FOR CLARITY)  
SCALE 1:1



SHOP COPY  
RETURN TO  
ENGINEERING  
UNCONTROLLED COPY  
SUBJECT TO AMENDMENT  
WITHOUT NOTICE  
WORK ORDER  
NO. 34083

### D3471-043 SUPPORT & CLAMP ASS'Y

#### NOTES:

- 1) TOLERANCES ARE PER DART QSI 018 UNLESS OTHERWISE NOTED
- 2) ALL DIMENSIONS ARE IN INCHES
- 3) BREAK ALL SHARP EDGES 0.005 TO 0.010

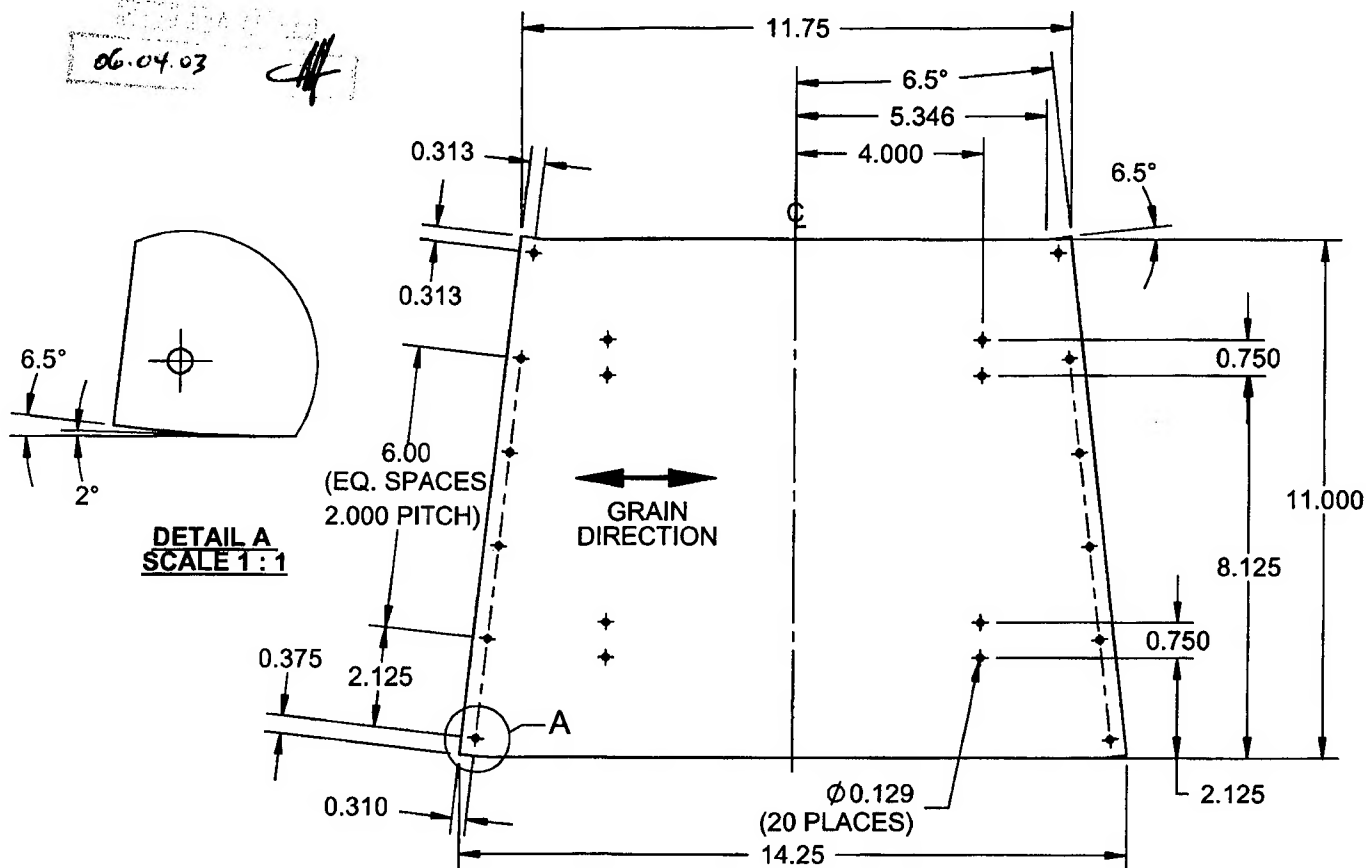
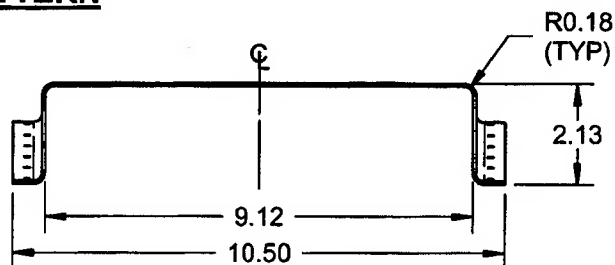
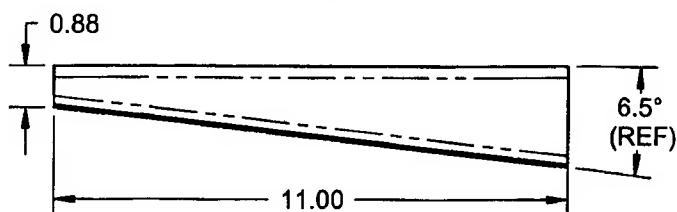
| QTY<br>-043 | P/N        | DESCRIPTION                |
|-------------|------------|----------------------------|
| X           | D3471-043  | SUPPORT AND CLAMP ASSEMBLY |
| 1           | D3471-3    | SUPPORT                    |
| 3           | MS20427M-4 | RIVET                      |
| 1           | MS35842-16 | CLAMP                      |

**COPYRIGHT © 2005 BY DART AEROSPACE LTD.**

THIS DOCUMENT IS PRIVATE AND CONFIDENTIAL AND IS SUPPLIED ON THE EXPRESS CONDITION THAT IT IS NOT TO BE USED FOR ANY PURPOSE OR COPIED OR COMMUNICATED TO ANY OTHER PERSON WITHOUT WRITTEN PERMISSION FROM DART AEROSPACE LTD.

**DART**

|                               |                                |  |                        |
|-------------------------------|--------------------------------|--|------------------------|
| DESIGN<br><i>[Signature]</i>  | DRAWN BY<br><i>[Signature]</i> | <b>DART AEROSPACE LTD</b><br>HAWKESBURY, ONTARIO, CANADA |                        |
| CHECKED<br><i>[Signature]</i> | APPROVED<br><i>[Signature]</i> | DRAWING NO.<br><b>D3471</b>                              | REV. A<br>SHEET 3 OF 5 |
| DATE<br><b>05.12.21</b>       |                                | TITLE<br><b>BLOWER MOTOR SUPPORT</b>                     | SCALE<br>1:4           |

**D3471-1F BASE FLAT PATTERN****D3471-1 BASE BENDING DETAIL****NOTES:**

- 1) MATERIAL: 2024-T3 ALUMINUM SHEET (0.063" THICK)  
PER QQ-A-250/4 OR AMS 4037  
(REF. DART SPEC. M2024T3S.063)
- 2) FINISH: CHEMICAL CONVERSION COAT PER DART QSI 005 4.1
- 3) PART IS SYMMETRICAL ABOUT CENTER LINE
- 4) ALL DIMENSIONS ARE IN INCHES
- 5) BREAK ALL SHARP EDGES 0.005 TO 0.010

SHOP COPY  
RETURN TO  
ENGINEERING  
UNCONTROLLED COPY  
SUBJECT TO AMENDMENT  
WITHOUT NOTICE  
WORK ORDER  
NO. *34083*

**COPYRIGHT © 2005 BY DART AEROSPACE LTD.**

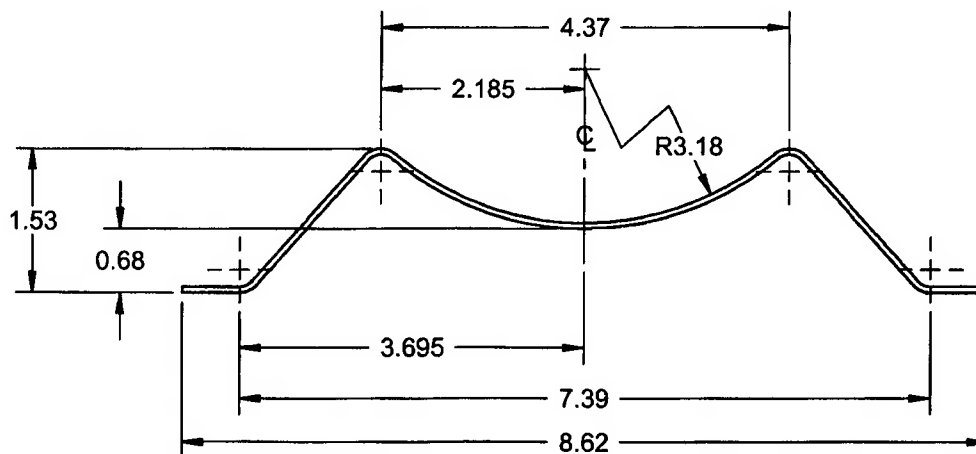
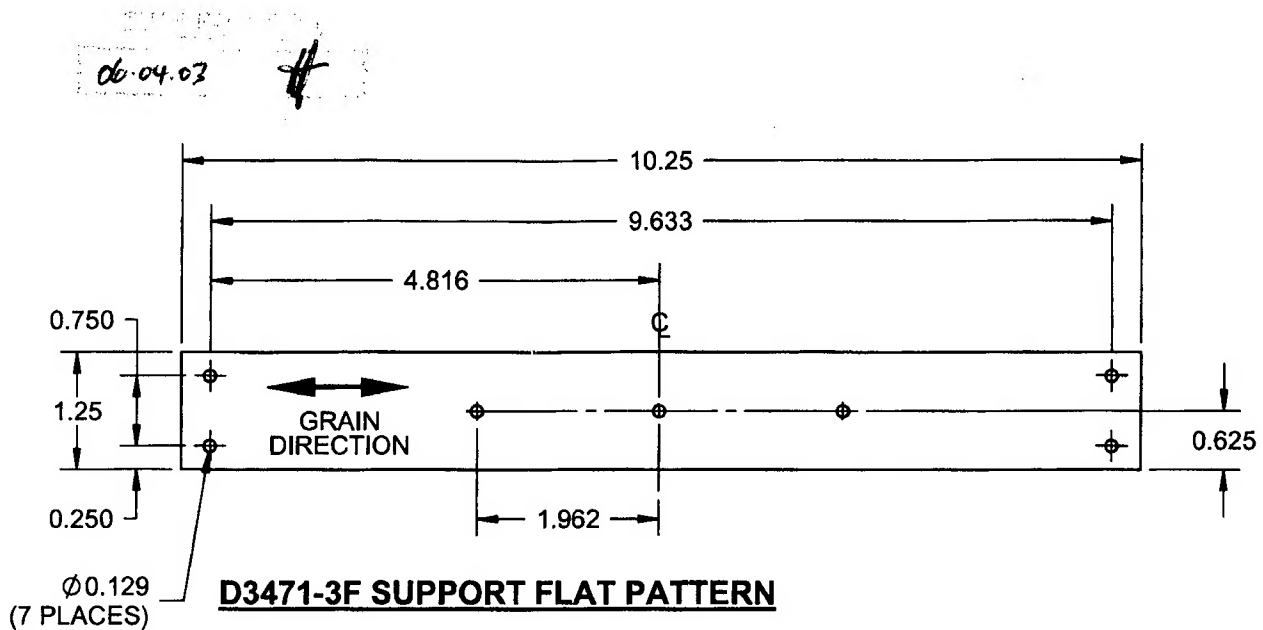
THIS DOCUMENT IS PRIVATE AND CONFIDENTIAL AND IS SUPPLIED ON THE EXPRESS CONDITION THAT IT IS NOT TO BE USED FOR ANY PURPOSE OR COPIED OR COMMUNICATED TO ANY OTHER PERSON WITHOUT WRITTEN PERMISSION FROM DART AEROSPACE LTD.





**DART**

|                               |                                |  |                              |
|-------------------------------|--------------------------------|--|------------------------------|
| DESIGN<br><i>[Signature]</i>  | DRAWN BY<br><i>[Signature]</i> | <b>DART AEROSPACE LTD</b><br>HAWKESBURY, ONTARIO, CANADA |                              |
| CHECKED<br><i>[Signature]</i> | APPROVED<br><i>[Signature]</i> | DRAWING NO.<br><b>D3471</b>                              | REV. A                       |
| DATE<br><b>05.12.21</b>       |                                | TITLE<br><b>BLOWER MOTOR SUPPORT</b>                     | SHEET 4 OF 5<br>SCALE<br>1:2 |

**NOTES:**

- 1) MATERIAL: 2024-T3 ALUMINUM SHEET (0.063 THICK)  
PER AMS-QQ-A-250/4 OR AMS 4037  
(REF. DART SPEC. M2024T3S.063)
- 2) FINISH: CHEMICAL CONVERSION COAT PER DART QSI 005 4.1
- 2) PART IS SYMETRICAL ABOUT CENTER LINE
- 3) ALL DIMENSIONS ARE IN INCHES
- 4) BREAK ALL SHARP EDGES 0.005 TO 0.010

SHOP COPY  
RETURN TO  
ENGINEERING  
UNCONTROLLED COPY  
SUBJECT TO AMENDMENT  
WITHOUT NOTICE  
WORK ORDER  
NO. **34083**

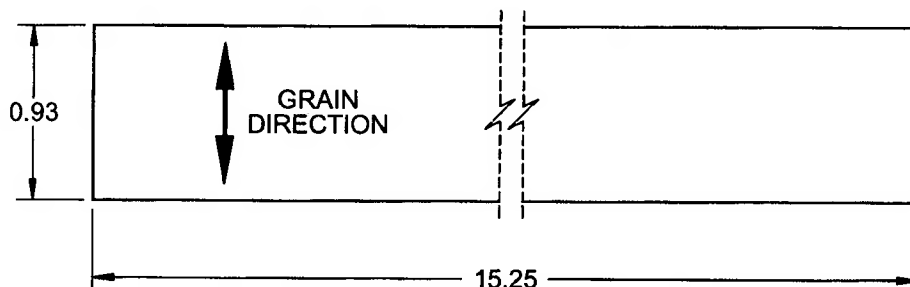
**COPYRIGHT © 2005 BY DART AEROSPACE LTD.**

THIS DOCUMENT IS PRIVATE AND CONFIDENTIAL AND IS SUPPLIED ON THE EXPRESS CONDITION THAT IT IS NOT TO BE USED FOR ANY PURPOSE OR COPIED OR COMMUNICATED TO ANY OTHER PERSON WITHOUT WRITTEN PERMISSION FROM DART AEROSPACE LTD.

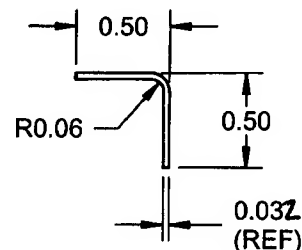


|                               |                                |  |                        |
|-------------------------------|--------------------------------|--|------------------------|
| DESIGN<br><i>[Signature]</i>  | DRAWN BY<br><i>[Signature]</i> | <b>DART AEROSPACE LTD</b><br>HAWKESBURY, ONTARIO, CANADA |                        |
| CHECKED<br><i>[Signature]</i> | APPROVED<br><i>[Signature]</i> | DRAWING NO.<br><b>D3471</b>                              | REV. A<br>SHEET 5 OF 5 |
| DATE<br><b>05.12.21</b>       |                                | TITLE<br><b>BLOWER MOTOR SUPPORT</b>                     | SCALE<br>1:1           |

06.04.03 *[Signature]*



**D3471-5F STIFFENER FLAT PATTERN**



**D3471-5 STIFFENER BENDING DETAIL**

**D3471-5 STIFFENER**

**NOTES:**

- 1) MATERIAL: 2024-T3 ALUMINUM SHEET (0.032" THICK)  
PER QQ-A-250/4 OR AMS 4037  
(REF. DART SPEC. M2024T3S.032)
- 2) FINISH: CHEMICAL CONVERSION COAT PER DART QSI 005 4.1
- 3) TOLERANCES ARE PER DART QSI 018 UNLESS OTHERWISE NOTED
- 4) ALL DIMENSIONS ARE IN INCHES
- 5) BREAK ALL SHARP EDGES 0.005 TO 0.010

SHOP COPY  
RETURN TO  
ENGINEERING  
UNCONTROLLED COPY  
SUBJECT TO AMENDMENT  
WITHOUT NOTICE  
WORK ORDER  
NO. **34083**

**COPYRIGHT © 2005 BY DART AEROSPACE LTD.**

THIS DOCUMENT IS PRIVATE AND CONFIDENTIAL AND IS SUPPLIED ON THE EXPRESS CONDITION THAT IT IS NOT TO BE USED FOR ANY PURPOSE OR COPIED OR COMMUNICATED TO ANY OTHER PERSON WITHOUT WRITTEN PERMISSION FROM DART AEROSPACE LTD.